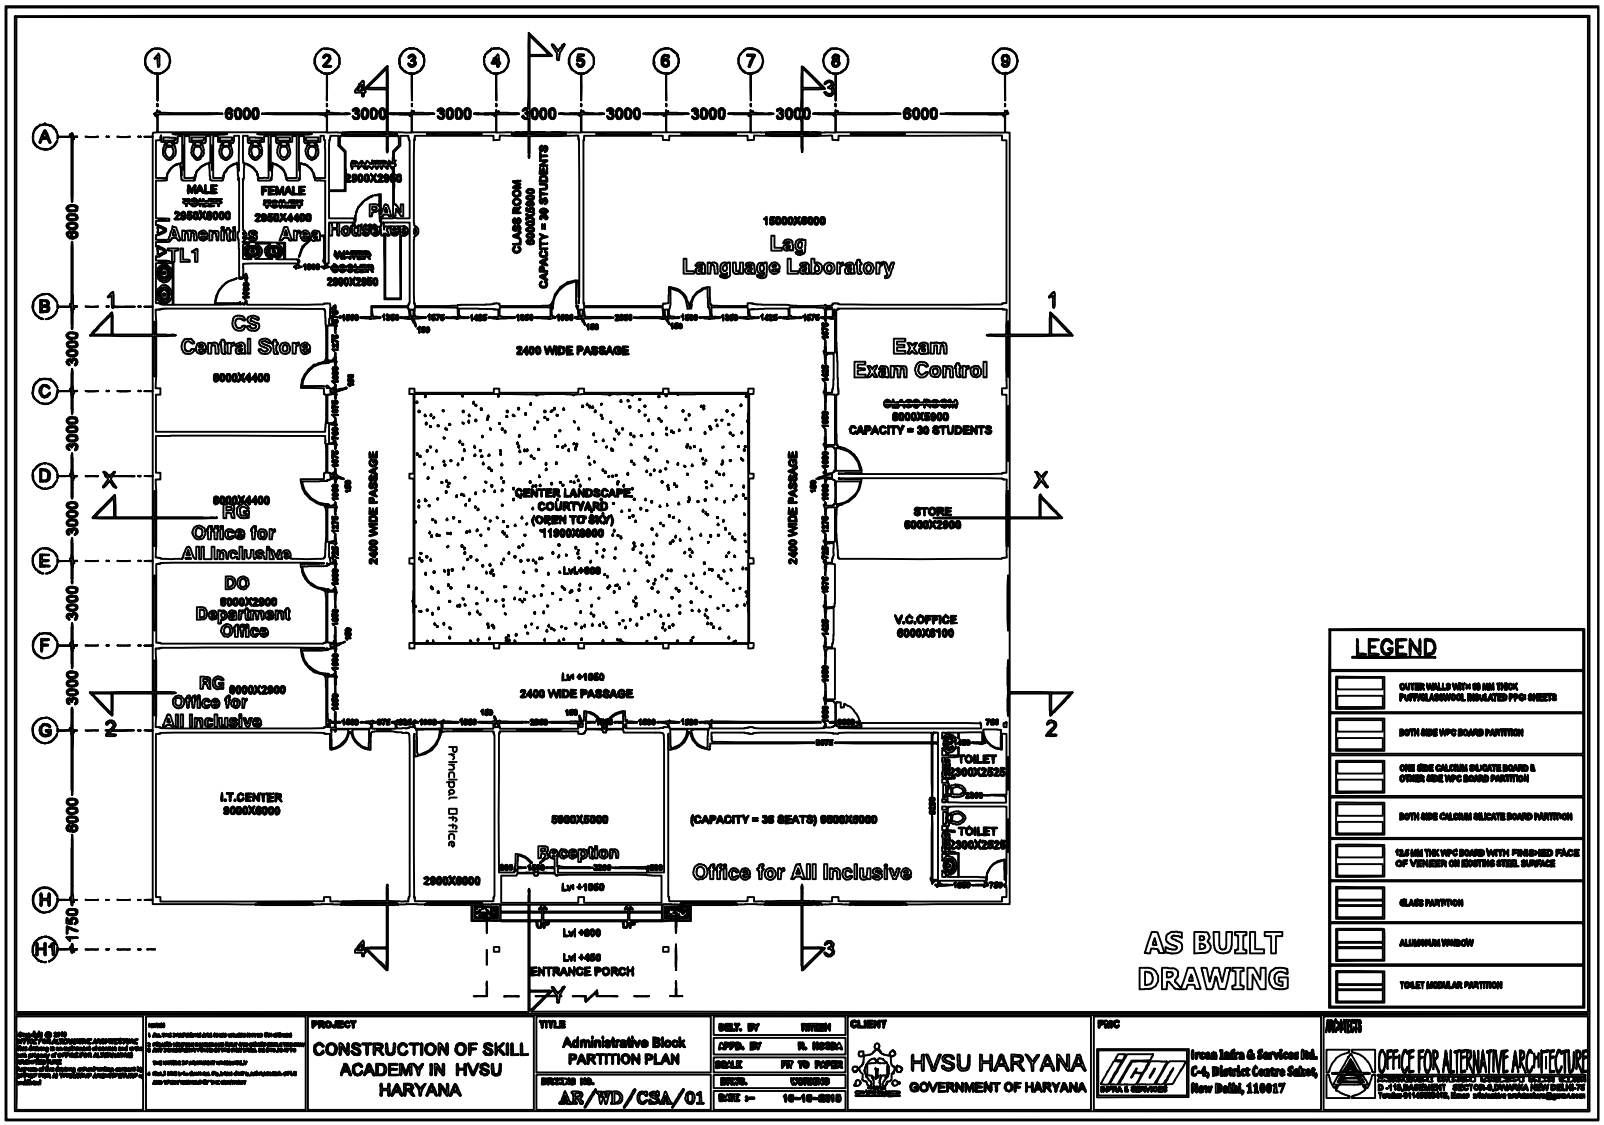

MALE TOILET 2950X6000
FEMALE TOILET 2950X4400
Amenities Area TL1
PANTRY 2900X2900
PAN Housekeep
WATER COOLER 2900X2950
CLASS ROOM 6000X5900 CAPACITY = 30 STUDENTS
15000X6000
Lag Language Laboratory
CS Central Store
6000X4400
2400 WIDE PASSAGE
Exam Exam Control
CLASS ROOM 6000X5900 CAPACITY = 30 STUDENTS
CENTER LANDSCAPE COURTYARD (OPEN TO SKY) 11900X6000
Lvl +600
STORE 6000X2900
RG Office for All Inclusive
DO 6000X2900 Department Office
V.C.OFFICE 6000X6100
RG Office for All Inclusive
Lvl +1050
I.T.CENTER 9000X6000
Principal Office
2900X6000
5900X5000
Reception
(CAPACITY = 36 SEATS) 6000X6000
Office for All Inclusive
TOILET 2300X2525
Lvl +1050
Lvl +600
Lvl +450
ENTRANCE PORCH
AS BUILT DRAWING
LEGEND
OUTER WALLS WITH 60 MM THICK PUFF/GLASSWOOL INSULATED PPGI SHEETS
BOTH SIDE WPC BOARD PARTITION
ONE SIDE CALCIUM SILICATE BOARD & OTHER SIDE WPC BOARD PARTITION
BOTH SIDE CALCIUM SILICATE BOARD PARTITION
12.5 MM THK WPC BOARD WITH FINISHED FACE OF VENEER ON EXISTING STEEL SURFACE
GLASS PARTITION
ALUMINIUM WINDOW
TOILET MODULAR PARTITION
PROJECT
CONSTRUCTION OF SKILL ACADEMY IN HVSU HARYANA
TITLE
Administrative Block PARTITION PLAN
DRAWING NO.
AR/WD/CSA/01
DELT. BY
APPD. BY
SCALE
DATE :-
CLIENT
HVSU HARYANA
GOVERNMENT OF HARYANA
PMC
Ircon Infra & Services Ltd.
C-4, District Centre Saket,
New Delhi, 110017
ARCHITECTS
OFFICE FOR ALTERNATIVE ARCHITECTURE